



PAID WESTPORT WESTON HEALTH DISTRICT

180 Bayberry Lane, Westport, CT 06880-2855

Telephone: (203) 227-9571

MAY 05 2020

WWHD

Fee is non-refundable.

\$ 245⁰⁰ Initials: JK

APPLICATION FOR A BUILDING ADDITION, BUILDING CONVERSION, RENOVATION OR ACCESSORY STRUCTURE

Date: 5/27/20 Owner's Name: Paula McInerney

Property Address: 6 Manitou Court Westport 06880 Tel. No.: _____
Street Town ZIP

Type of Application: Building Addition Renovation Accessory Structure (Deck, Garage, Porch) Building Conversion, Change in Use (Winterization)

Give a Brief Description of Proposed Application: (Performing winterization; type and number of rooms being added; square footage of house addition, type of structures to be added, and foot print change, etc.)

The owner proposes to renovate an existing house and construct a barn addition. The renovated house will consist of 3 bedrooms however the proposed septic has been designed for a 5 bedroom house to account for additional flows

Addition/Renovation: No. of bedrooms: 5 No. of bathrooms: 6 No. water use fixtures 9
Increase in house footprint? Yes No No. of other rooms: 11 No. of tubs more than 99 gal.: 0 Heat? Yes No
Approximate proposed increase in floor area (in Sq. Ft.) 3,485 Are footing or foundation drains required? Yes No

Existing Structure: Residential Non-Residential (Describe): _____
No. of bedrooms: 3 No. of bathrooms: 3.5 No. of oversized tubs (>99 gal.) 0
Approximate floor area (in Sq. Ft.) 1,185 Water supply: Private well Public water
Footing or foundation drains present? Yes No

Existing Septic Year system was installed? 1995 New Repair Public sewer available? Yes No
Size of septic tank: 1,500 gals. Size and type of leaching system: 60 LF Eljen Mantis DW-100
Curtain drain? Yes No Has any soil testing been performed on the property? Yes No
If yes, when and by whom? Soils Performed BY Landtech witnessed by WWHD February 14, 2020

Owner or Duly Authorized Representative (Print) Andy Soumelidis/Landtech Contact Phone Number: 203-454-2110
Signed: [Signature] 5/27/20
Owner or Duly Authorized Representative Date

WWHD REMARKS:

- Compliance with 19-13-B100a required..... Yes No
- Soils evaluation required..... Yes No
- Wetlands..... Yes No Don't know
- Possible storm drainage structure required by Engineering..... Yes No
- SSDS proposal required..... Yes No

Comments: new SDS to be installed prior to final inspection

APPROVAL: Approved: [Signature] DATE: 6/9/2020

FINAL WWHD INSPECTION REQUIRED AT COMPLETION OF JOB		Yes <input checked="" type="checkbox"/>	No <input type="checkbox"/>
Final Inspection	Final Inspection/Final Approval: _____	Sanitarian	Date



PAID
MAY 05 2020

APPLICATION FOR REVIEW OF PLANS FOR PROPOSED SWIMMING POOL/SPA

Please TYPE or PRINT. Complete all items to bold line. Two copies of plot plan must be submitted with this application.

Location: 6 Manitou Court Westport Weston
Street Address Lot Number

Owner: Paula McInerney Address: 2 Manitou Court Tel: ()

Built By: Desmond Builders Address: 35 Old Post Rd, Southport Tel: (203) 259-7323

Type of Pool: Indoor hydro pool

Size of Pool: 7'x25'

Distance of Pool From:

Dwelling: Indoor Water Course/Wetlands N/A

Septic Tank: +/-60' Leaching Area: +/-100'

Well: N/A

Drinking Water Supply: Public Private

Pool Filter:

Type: MOD Filter Size:


Location (Show on plan): indoor, lower level

Source of water:

Location of draining wastewater discharge, if applicable:

Brief Description of Application: Proposed indoor pool


Has any soil testing been performed on the property? Yes No
If yes, when and by whom? Soils Performed BY Landtech witnessed by WWHD February 14, 2020

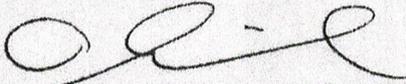Signed:  4/30/20
Owner or Duly Authorized Representative Date

WWHD REMARKS:

- Compliance with 19-13-B100a required..... Yes No
- Soils evaluation required Yes No
- SSDS proposal required Yes No
- Permit to Construct required (if accessory structures proposed)..... Yes No
- Surveyors as-built required Yes No

Conditions: no backwash to ground surface

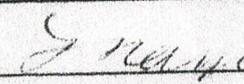
APPROVAL: Approved:  Date: 6/9/2020

FINAL WWHD INSPECTION REQUIRED AT COMPLETION OF JOB Yes No
It is the responsibility of the contractor or homeowner to arrange for final inspection.

Final Inspection

Final Inspection/Final Approval: _____ Sanitarian _____ Date _____

Remarks: _____

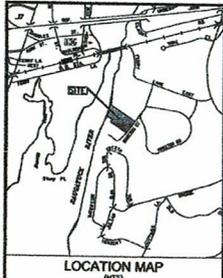

GENERAL NOTES
 1. LOT LINE & TOPOGRAPHY INFORMATION FOR 8 MANITOU COURT TAKEN FROM ZONING MAP OF PROPERTY PREPARED BY DENNIS A. BELLAS LAND SURVEYORS DATED MARCH 16, 2006.


DEMOLITION LEGEND

- EXISTING BUILDINGS TO BE REMOVED
- EXISTING PAVEMENT AND WALKWAYS TO BE REMOVED

LEGEND

- | | |
|------------------------------|--|
| EXISTING SYMBOLS: | PROPOSED SYMBOLS: |
| ○ Iron Pin (Found) | ○ (CY) Stone Yard Drain |
| □ Monument (Found) | ● (4x4) Stone Drain Manhole |
| ○ Manhole | ○ (2x2) Catch Basin |
| ○ "CB" Catch Basin | ○ (2000R) Sanitary Sewer Manhole |
| ○ Utility Pole | ○ P-1 Pole Test Hole Location & Number |
| ○ Light Pole | ○ DTH-1 Deep Test Hole Location & Number |
| ○ Gas Meter | ○ Proposed Well |
| ○ Gas Meter | |
| ○ Existing Well | |
| EXISTING LINETYPES: | PROPOSED LINETYPES: |
| — Property Line | — Secondary Sewer |
| — Sanitary Sewer Line | — Electric Service |
| — UG Gas Line | — Water Service |
| — Water Line | — UG Telephone Service |
| — Overhead Utilities | — Electric/Telephone Service |
| — UG Telephone Line | — Primary Septic |
| — UG Electric/Telephone Line | — Retaining Wall |
| — Wood/Chain Link Fence | — Contour |
| — Stone Ret. Wall | — Spot Elevation |
| — Contour | — SR Fence (SRP) |
| — Wetland Limit | — Wood/Chain Link Fence |
| — Spot Elevation | — Quarantine Fence |
| — Wetland Limit | — Vegetative Buffer |
| — Drainage Line | — Wetland Limit (Proposed) |
| — Town/City Line | |
| — 20 Year Flood Line | |
| — 100 Year Flood Line | |
| — FEMA Flood Zone Line | |
| — Property Boundary | |
| — Mean High Water | |
| — Coastal Jurisdiction Line | |

SAUGATICK RIVER

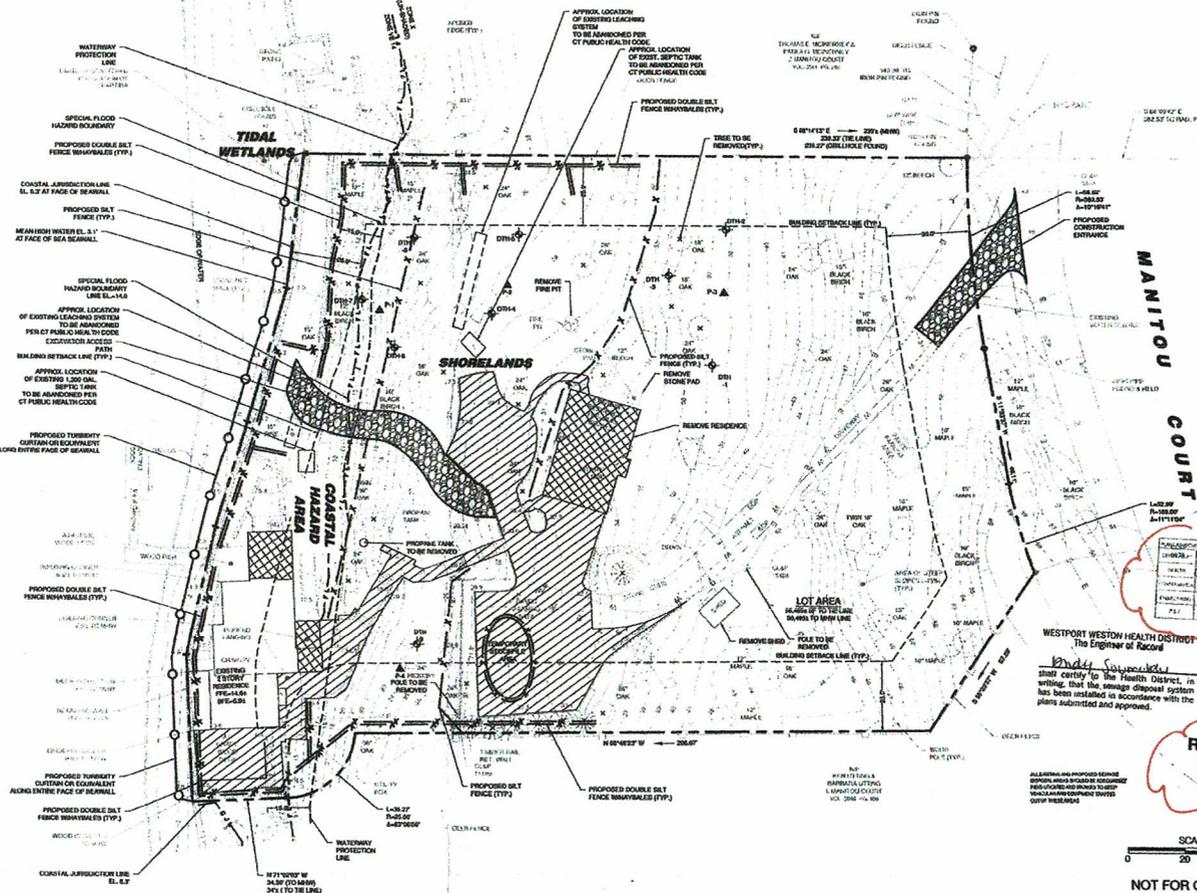

Robert J. Scott
Christie A. Ryan

WESTPORT WESTON HEALTH DISTRICT
 The Engineer of Record

RECEIVED
 MAY 28 2020
 WWHD

SCALE IN FEET
 0 20 40 60

NOT FOR CONSTRUCTION
 FOR REVIEW AND APPROVAL
 BY PUBLIC AGENCIES ONLY



PROJECT NO.	20200-01
SCALE	1" = 20'
DRAWN BY	SM
CHECKED BY	AS
DATE	05/28/20
PROJECT	PROPOSED SITE IMPROVEMENTS FOR A SINGLE FAMILY ADDITION AND RENOVATION - DEMOLITION PLAN
DATE	05/28/20
PROJECT	8 MANITOU COURT WESTPORT, CT
DATE	05/28/20
PROJECT	PROPOSED SITE IMPROVEMENTS FOR A SINGLE FAMILY ADDITION AND RENOVATION - DEMOLITION PLAN
DATE	05/28/20

LANDTECH
 118 Prudence Avenue • Westport, Connecticut 06880 • 203-464-6100 • info@landtech.com

8 MANITOU COURT, LLC
 8 MANITOU COURT
 WESTPORT, CT
 PROPOSED SITE IMPROVEMENTS FOR A SINGLE FAMILY ADDITION
 AND RENOVATION - DEMOLITION PLAN

C-0




6 MANITOU COURT

Westport, Connecticut 06680

ARCHITECTURAL ABBREVIATIONS

AC - AIR CONDITIONING	AD - ADJUSTABLE	AG - AIR GARD	AL - ALUMINUM	AS - ASPHALT	AT - ASPHALT TILE
AW - ACRYLIC WALL	BA - BATH	BC - BRICK	BL - BRASS	BO - BOND	BP - BRICK PATTERN
BS - BRICK SLIP	BU - BUTYL	CA - CONCRETE	CB - CEMENT BOARD	CC - CONCRETE CURB	CD - CONCRETE DETAIL
CE - CEMENT	CF - CEMENT FLOOR	CG - CONCRETE GROUT	CH - CHINA	CI - CONCRETE INSULATION	CL - CONCRETE LINING
CM - CONCRETE MASONRY	CO - COATING	CP - CONCRETE PAVING	CS - CONCRETE SURFACE	CT - CONCRETE TYPICAL	CU - CONCRETE UNDERLAYMENT
CV - CONCRETE VENEER	DA - DRYWALL	DB - DRYWALL BOARD	DC - DRYWALL CURB	DD - DRYWALL DETAIL	DE - DRYWALL END
DF - DRYWALL FINISH	DI - DRYWALL INSULATION	DL - DRYWALL LINING	DM - DRYWALL MASONRY	DN - DRYWALL NORTH	DO - DRYWALL OVER
EA - EXTERIOR ANGLE	EB - EXTERIOR BRICK	EC - EXTERIOR CONCRETE	ED - EXTERIOR DETAIL	EE - EXTERIOR END	EF - EXTERIOR FINISH
EG - EXTERIOR GROUT	EH - EXTERIOR INSULATION	EI - EXTERIOR LINING	EJ - EXTERIOR MASONRY	EK - EXTERIOR NORTH	EL - EXTERIOR OVER
EM - EXTERIOR MASONRY	EN - EXTERIOR NORTH	EO - EXTERIOR OVER	EP - EXTERIOR PAVING	EQ - EXTERIOR PAVING DETAIL	ER - EXTERIOR PAVING END
ES - EXTERIOR SURFACE	ET - EXTERIOR TYPICAL	EU - EXTERIOR UNDERLAYMENT	EV - EXTERIOR VENEER	EW - EXTERIOR WALL	EX - EXTERIOR WINDOW
FA - FLOOR ANGLE	FB - FLOOR BRICK	FC - FLOOR CONCRETE	FD - FLOOR DETAIL	FE - FLOOR END	FF - FLOOR FINISH
FG - FLOOR GROUT	FH - FLOOR INSULATION	FI - FLOOR LINING	FJ - FLOOR MASONRY	FK - FLOOR NORTH	FL - FLOOR OVER
FM - FLOOR MASONRY	FN - FLOOR NORTH	FO - FLOOR OVER	FP - FLOOR PAVING	FQ - FLOOR PAVING DETAIL	FR - FLOOR PAVING END
FS - FLOOR SURFACE	FT - FLOOR TYPICAL	FU - FLOOR UNDERLAYMENT	FV - FLOOR VENEER	FW - FLOOR WALL	FX - FLOOR WINDOW
GA - GARDEN	GB - GARDEN BRICK	GC - GARDEN CONCRETE	GD - GARDEN DETAIL	GE - GARDEN END	GF - GARDEN FINISH
GG - GARDEN GROUT	GH - GARDEN INSULATION	GI - GARDEN LINING	GJ - GARDEN MASONRY	GK - GARDEN NORTH	GL - GARDEN OVER
GM - GARDEN MASONRY	GN - GARDEN NORTH	GO - GARDEN OVER	GP - GARDEN PAVING	GQ - GARDEN PAVING DETAIL	GR - GARDEN PAVING END
GS - GARDEN SURFACE	GT - GARDEN TYPICAL	GU - GARDEN UNDERLAYMENT	GV - GARDEN VENEER	GW - GARDEN WALL	GX - GARDEN WINDOW
HA - HANGING ANGLE	HB - HANGING BRICK	HC - HANGING CONCRETE	HD - HANGING DETAIL	HE - HANGING END	HF - HANGING FINISH
HG - HANGING GROUT	HH - HANGING INSULATION	HI - HANGING LINING	HJ - HANGING MASONRY	HK - HANGING NORTH	HL - HANGING OVER
HM - HANGING MASONRY	HN - HANGING NORTH	HO - HANGING OVER	HP - HANGING PAVING	HQ - HANGING PAVING DETAIL	HR - HANGING PAVING END
HS - HANGING SURFACE	HT - HANGING TYPICAL	HU - HANGING UNDERLAYMENT	HV - HANGING VENEER	HW - HANGING WALL	HX - HANGING WINDOW
IA - INTERIOR ANGLE	IB - INTERIOR BRICK	IC - INTERIOR CONCRETE	ID - INTERIOR DETAIL	IE - INTERIOR END	IF - INTERIOR FINISH
IG - INTERIOR GROUT	IH - INTERIOR INSULATION	II - INTERIOR LINING	IJ - INTERIOR MASONRY	IK - INTERIOR NORTH	IL - INTERIOR OVER
IM - INTERIOR MASONRY	IN - INTERIOR NORTH	IO - INTERIOR OVER	IP - INTERIOR PAVING	IQ - INTERIOR PAVING DETAIL	IR - INTERIOR PAVING END
IS - INTERIOR SURFACE	IT - INTERIOR TYPICAL	IU - INTERIOR UNDERLAYMENT	IV - INTERIOR VENEER	IW - INTERIOR WALL	IX - INTERIOR WINDOW
JA - JOINT ANGLE	JB - JOINT BRICK	JC - JOINT CONCRETE	JD - JOINT DETAIL	JE - JOINT END	JF - JOINT FINISH
JG - JOINT GROUT	JH - JOINT INSULATION	JI - JOINT LINING	JJ - JOINT MASONRY	JK - JOINT NORTH	JL - JOINT OVER
JM - JOINT MASONRY	JN - JOINT NORTH	JO - JOINT OVER	JP - JOINT PAVING	JQ - JOINT PAVING DETAIL	JR - JOINT PAVING END
JS - JOINT SURFACE	JT - JOINT TYPICAL	JU - JOINT UNDERLAYMENT	JV - JOINT VENEER	JW - JOINT WALL	JX - JOINT WINDOW
KA - KITCHEN ANGLE	KB - KITCHEN BRICK	KC - KITCHEN CONCRETE	KD - KITCHEN DETAIL	KE - KITCHEN END	KF - KITCHEN FINISH
KG - KITCHEN GROUT	KH - KITCHEN INSULATION	KI - KITCHEN LINING	KJ - KITCHEN MASONRY	KK - KITCHEN NORTH	KL - KITCHEN OVER
KM - KITCHEN MASONRY	KN - KITCHEN NORTH	KO - KITCHEN OVER	KP - KITCHEN PAVING	KQ - KITCHEN PAVING DETAIL	KR - KITCHEN PAVING END
KS - KITCHEN SURFACE	KT - KITCHEN TYPICAL	KU - KITCHEN UNDERLAYMENT	KV - KITCHEN VENEER	KW - KITCHEN WALL	KX - KITCHEN WINDOW
LA - LIVING ANGLE	LB - LIVING BRICK	LC - LIVING CONCRETE	LD - LIVING DETAIL	LE - LIVING END	LF - LIVING FINISH
LG - LIVING GROUT	LH - LIVING INSULATION	LI - LIVING LINING	LJ - LIVING MASONRY	LK - LIVING NORTH	LL - LIVING OVER
LM - LIVING MASONRY	LN - LIVING NORTH	LO - LIVING OVER	LP - LIVING PAVING	LQ - LIVING PAVING DETAIL	LR - LIVING PAVING END
LS - LIVING SURFACE	LT - LIVING TYPICAL	LU - LIVING UNDERLAYMENT	LV - LIVING VENEER	LW - LIVING WALL	LX - LIVING WINDOW
MA - MASONRY ANGLE	MB - MASONRY BRICK	MC - MASONRY CONCRETE	MD - MASONRY DETAIL	ME - MASONRY END	MF - MASONRY FINISH
MG - MASONRY GROUT	MH - MASONRY INSULATION	MI - MASONRY LINING	MJ - MASONRY MASONRY	MK - MASONRY NORTH	ML - MASONRY OVER
MM - MASONRY MASONRY	MN - MASONRY NORTH	MO - MASONRY OVER	MP - MASONRY PAVING	MQ - MASONRY PAVING DETAIL	MR - MASONRY PAVING END
MS - MASONRY SURFACE	MT - MASONRY TYPICAL	MU - MASONRY UNDERLAYMENT	MV - MASONRY VENEER	MW - MASONRY WALL	MX - MASONRY WINDOW
NA - NORTH ANGLE	NB - NORTH BRICK	NC - NORTH CONCRETE	ND - NORTH DETAIL	NE - NORTH END	NF - NORTH FINISH
NG - NORTH GROUT	NH - NORTH INSULATION	NI - NORTH LINING	NJ - NORTH MASONRY	NK - NORTH NORTH	NL - NORTH OVER
NO - NORTH OVER	NP - NORTH PAVING	NQ - NORTH PAVING DETAIL	NR - NORTH PAVING END	NS - NORTH SURFACE	NT - NORTH TYPICAL
NU - NORTH UNDERLAYMENT	NV - NORTH VENEER	NW - NORTH WALL	NX - NORTH WINDOW	OA - OFFICE ANGLE	OB - OFFICE BRICK
OC - OFFICE CONCRETE	OD - OFFICE DETAIL	OE - OFFICE END	OF - OFFICE FINISH	OG - OFFICE GROUT	OH - OFFICE INSULATION
OI - OFFICE LINING	OJ - OFFICE MASONRY	OK - OFFICE NORTH	OL - OFFICE OVER	OP - OFFICE PAVING	OQ - OFFICE PAVING DETAIL
OR - OFFICE PAVING END	OS - OFFICE SURFACE	OT - OFFICE TYPICAL	OU - OFFICE UNDERLAYMENT	OV - OFFICE VENEER	OW - OFFICE WALL
OX - OFFICE WINDOW	PA - PORCH ANGLE	PB - PORCH BRICK	PC - PORCH CONCRETE	PD - PORCH DETAIL	PE - PORCH END
PF - PORCH FINISH	PG - PORCH GROUT	PH - PORCH INSULATION	PI - PORCH LINING	PJ - PORCH MASONRY	PK - PORCH NORTH
PL - PORCH OVER	PM - PORCH PAVING	PN - PORCH PAVING DETAIL	PR - PORCH PAVING END	PS - PORCH SURFACE	PT - PORCH TYPICAL
PU - PORCH UNDERLAYMENT	PV - PORCH VENEER	PW - PORCH WALL	PX - PORCH WINDOW	QA - QUARTER ANGLE	QB - QUARTER BRICK
QC - QUARTER CONCRETE	QD - QUARTER DETAIL	QE - QUARTER END	QF - QUARTER FINISH	QG - QUARTER GROUT	QH - QUARTER INSULATION
QI - QUARTER LINING	QJ - QUARTER MASONRY	QK - QUARTER NORTH	QL - QUARTER OVER	QP - QUARTER PAVING	QQ - QUARTER PAVING DETAIL
QR - QUARTER PAVING END	QS - QUARTER SURFACE	QT - QUARTER TYPICAL	QU - QUARTER UNDERLAYMENT	QV - QUARTER VENEER	QW - QUARTER WALL
QX - QUARTER WINDOW	RA - RAMP ANGLE	RB - RAMP BRICK	RC - RAMP CONCRETE	RD - RAMP DETAIL	RE - RAMP END
RF - RAMP FINISH	RG - RAMP GROUT	RH - RAMP INSULATION	RI - RAMP LINING	RJ - RAMP MASONRY	RK - RAMP NORTH
RL - RAMP OVER	RM - RAMP PAVING	RN - RAMP PAVING DETAIL	RO - RAMP PAVING END	RS - RAMP SURFACE	RT - RAMP TYPICAL
RU - RAMP UNDERLAYMENT	RV - RAMP VENEER	RW - RAMP WALL	RX - RAMP WINDOW	SA - SLOPE ANGLE	SB - SLOPE BRICK
SC - SLOPE CONCRETE	SD - SLOPE DETAIL	SE - SLOPE END	SF - SLOPE FINISH	SG - SLOPE GROUT	SH - SLOPE INSULATION
SI - SLOPE LINING	SJ - SLOPE MASONRY	SK - SLOPE NORTH	SL - SLOPE OVER	SM - SLOPE PAVING	SN - SLOPE PAVING DETAIL
SO - SLOPE PAVING END	SS - SLOPE SURFACE	ST - SLOPE TYPICAL	SU - SLOPE UNDERLAYMENT	SV - SLOPE VENEER	SW - SLOPE WALL
SX - SLOPE WINDOW	TA - TERRACE ANGLE	TB - TERRACE BRICK	TC - TERRACE CONCRETE	TD - TERRACE DETAIL	TE - TERRACE END
TF - TERRACE FINISH	TG - TERRACE GROUT	TH - TERRACE INSULATION	TI - TERRACE LINING	TJ - TERRACE MASONRY	TK - TERRACE NORTH
TL - TERRACE OVER	TM - TERRACE PAVING	TN - TERRACE PAVING DETAIL	TO - TERRACE PAVING END	TS - TERRACE SURFACE	TT - TERRACE TYPICAL
TU - TERRACE UNDERLAYMENT	TV - TERRACE VENEER	TW - TERRACE WALL	TX - TERRACE WINDOW	UA - UNDER ANGLE	UB - UNDER BRICK
UC - UNDER CONCRETE	UD - UNDER DETAIL	UE - UNDER END	UF - UNDER FINISH	UG - UNDER GROUT	UH - UNDER INSULATION
UI - UNDER LINING	UJ - UNDER MASONRY	UK - UNDER NORTH	UL - UNDER OVER	UM - UNDER PAVING	UN - UNDER PAVING DETAIL
UR - UNDER PAVING END	US - UNDER SURFACE	UT - UNDER TYPICAL	UU - UNDER UNDERLAYMENT	UV - UNDER VENEER	UW - UNDER WALL
UX - UNDER WINDOW	VA - VENT ANGLE	VB - VENT BRICK	VC - VENT CONCRETE	VD - VENT DETAIL	VE - VENT END
VF - VENT FINISH	VG - VENT GROUT	VH - VENT INSULATION	VI - VENT LINING	VJ - VENT MASONRY	VK - VENT NORTH
VL - VENT OVER	VM - VENT PAVING	VN - VENT PAVING DETAIL	VO - VENT PAVING END	VS - VENT SURFACE	VT - VENT TYPICAL
VU - VENT UNDERLAYMENT	VV - VENT VENEER	VW - VENT WALL	VX - VENT WINDOW	WA - WALL ANGLE	WB - WALL BRICK
WC - WALL CONCRETE	WD - WALL DETAIL	WE - WALL END	WF - WALL FINISH	WG - WALL GROUT	WH - WALL INSULATION
WI - WALL LINING	WJ - WALL MASONRY	WK - WALL NORTH	WL - WALL OVER	WM - WALL PAVING	WN - WALL PAVING DETAIL
WO - WALL PAVING END	WS - WALL SURFACE	WT - WALL TYPICAL	WU - WALL UNDERLAYMENT	WV - WALL VENEER	WW - WALL WALL
WX - WALL WINDOW	XA - EXTERIOR ANGLE	XB - EXTERIOR BRICK	XC - EXTERIOR CONCRETE	XD - EXTERIOR DETAIL	XE - EXTERIOR END
XF - EXTERIOR FINISH	XG - EXTERIOR GROUT	XH - EXTERIOR INSULATION	XI - EXTERIOR LINING	XJ - EXTERIOR MASONRY	XK - EXTERIOR NORTH
XL - EXTERIOR OVER	XM - EXTERIOR PAVING	XN - EXTERIOR PAVING DETAIL	XO - EXTERIOR PAVING END	XS - EXTERIOR SURFACE	XT - EXTERIOR TYPICAL
XU - EXTERIOR UNDERLAYMENT	XV - EXTERIOR VENEER	XW - EXTERIOR WALL	XX - EXTERIOR WINDOW	YA - YARD ANGLE	YB - YARD BRICK
YC - YARD CONCRETE	YD - YARD DETAIL	YE - YARD END	YF - YARD FINISH	YG - YARD GROUT	YH - YARD INSULATION
YI - YARD LINING	YJ - YARD MASONRY	YK - YARD NORTH	YL - YARD OVER	YM - YARD PAVING	YN - YARD PAVING DETAIL
YO - YARD PAVING END	YS - YARD SURFACE	YT - YARD TYPICAL	YU - YARD UNDERLAYMENT	YV - YARD VENEER	YW - YARD WALL
YX - YARD WINDOW	ZA - ZONE ANGLE	ZB - ZONE BRICK	ZC - ZONE CONCRETE	ZD - ZONE DETAIL	ZE - ZONE END
ZF - ZONE FINISH	ZG - ZONE GROUT	ZH - ZONE INSULATION	ZI - ZONE LINING	ZJ - ZONE MASONRY	ZK - ZONE NORTH
ZL - ZONE OVER	ZM - ZONE PAVING	ZN - ZONE PAVING DETAIL	ZO - ZONE PAVING END	ZS - ZONE SURFACE	ZT - ZONE TYPICAL
ZU - ZONE UNDERLAYMENT	ZV - ZONE VENEER	ZW - ZONE WALL	ZX - ZONE WINDOW		

GRAPHIC LEGEND

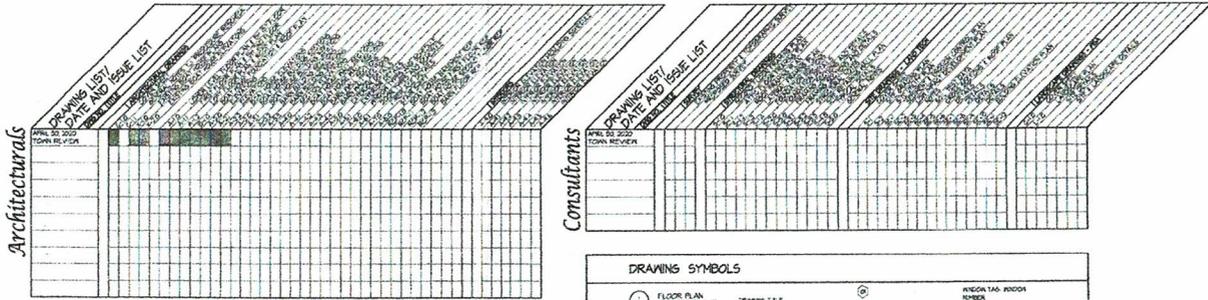


DRAWING SYMBOLS

LOCATION MAP: 1/8" = 10' SCALE

PROJECT TEAM:

OWNER: Thomas & Paula McManamy 2 Manitou Court Westport, CT 06680	ARCHITECT: Robert A. Cardelli Architects 60 First West Street Westport, CT 06680 Tel: (203) 852-2524 Attn: Robert A. Cardelli	SURVEYOR: Catherine DeAngelis 10 Elm Street Westport, CT 06680 Tel: (203) 230-8100	CIVIL ENGINEER: Lorenza 308 Riverside Avenue Westport, CT 06680 Tel: (203) 454-2100 Attn: Andy Spicciardi	LANDSCAPE ARCHITECT: Amanda S. Adams 48 Main Street New Canaan, CT 06840 Tel: (203) 466-3100 Attn: Cory Johnson	STRUCTURAL ENGINEER: John J. C... PO Box 374 Canaan, CT 06029 Tel: (860) 528-4444 Attn: Jennifer Peterson	MECHANICAL ENGINEER: 102	LIGHTING DESIGNER: 102	ENVIRONMENTAL ENGINEER: 102	CONTRACTOR: John Deppolito Builders Inc. 30 Old Post Road Salem, CT 06480 Tel: (203) 254-1000 Attn: George or John Deppolito
---	---	---	---	---	---	------------------------------------	----------------------------------	---------------------------------------	--

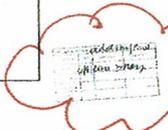

REVISIONS

DATE: 04/11/12
 DRAWN BY: JAC
 CHECKED BY: JAC
 TITLE: COVER SHEET

CLIENT ADDRESS:
 McManamy Residence
 2 Manitou Court
 Westport, CT 06680

TOWN REVIEW:
 4.30.20

RECEIVED
 APR 11 2012
 WWH

C-1.0