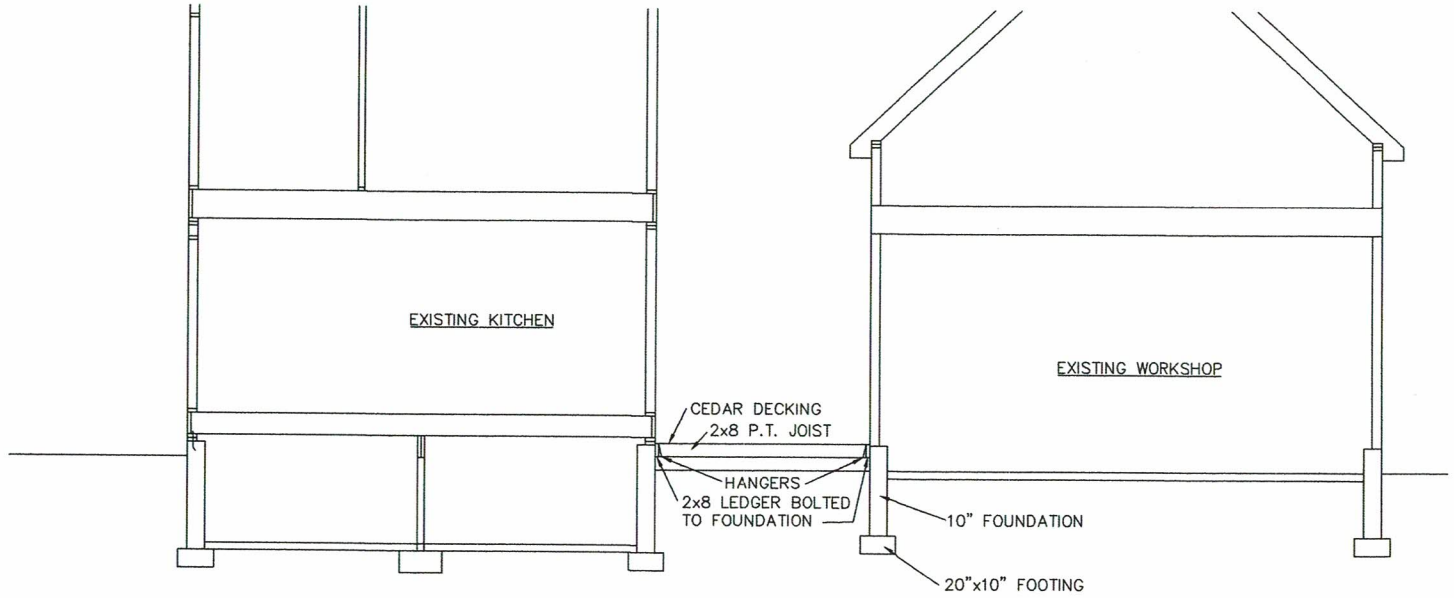

CROSS SECTION "A"
SCALE: 1/4"=1'-0"

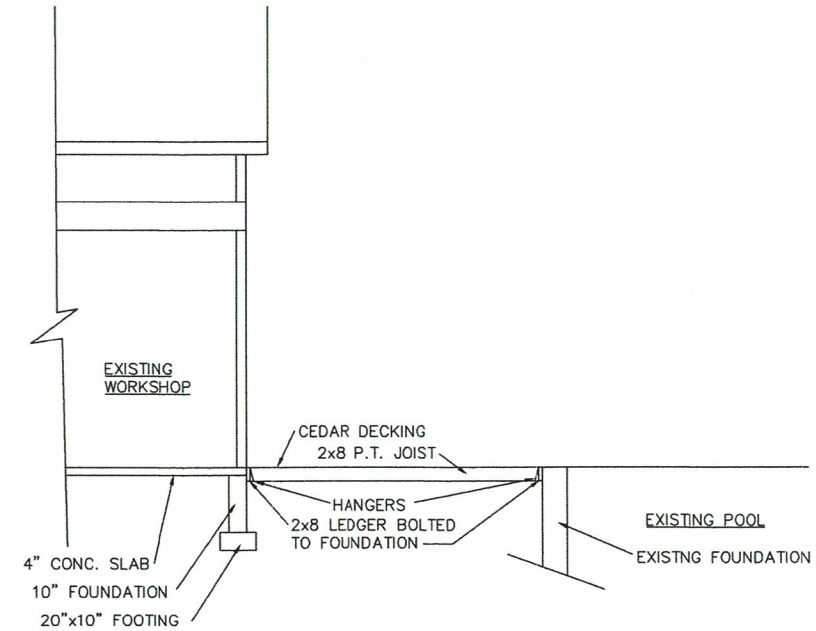

CROSS SECTION "B"
SCALE: 1/4"=1'-0"

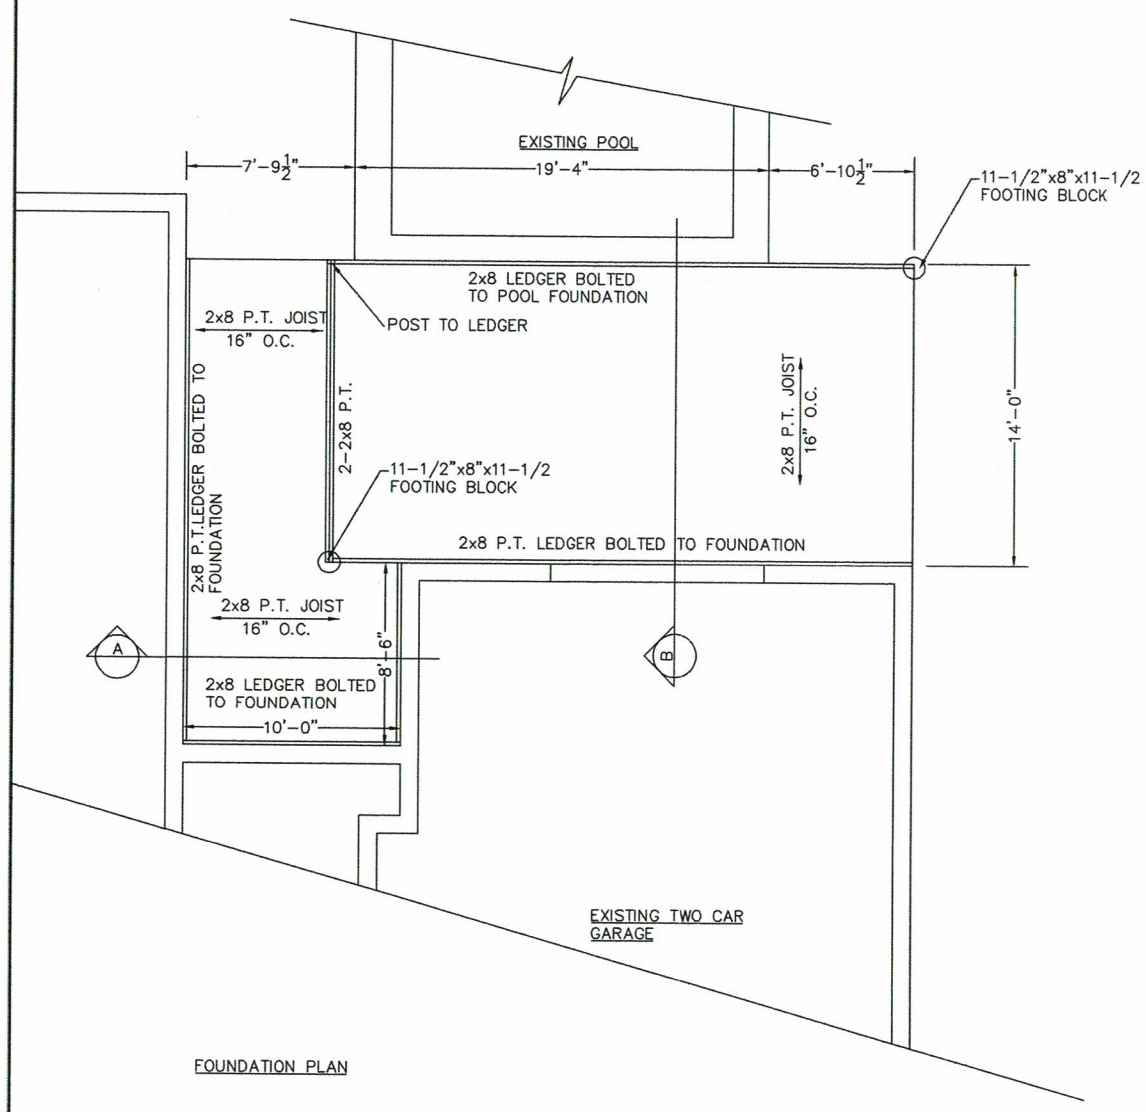

FOUNDATION PLAN

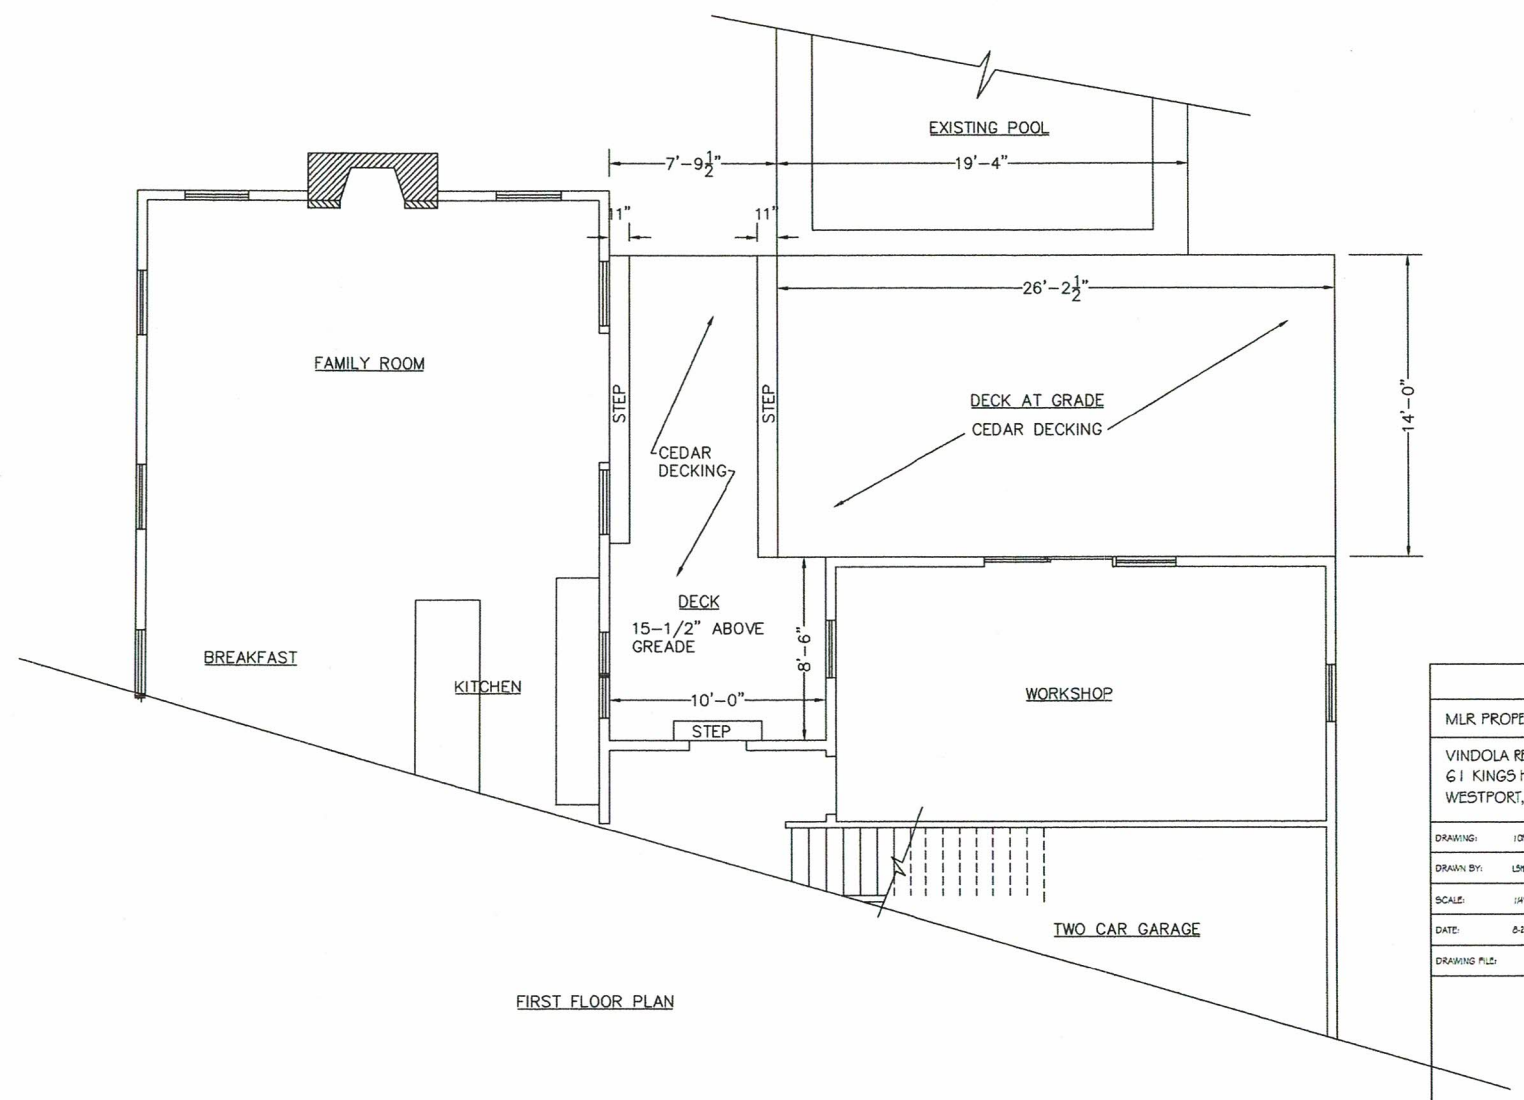

FIRST FLOOR PLAN

DECK AS BUILT

TITLE BLOCK		
MLR PROPERTIES LLC		
VINDOLA RESIDENCE 61 KINGS HIGHWAY SOUTH WESTPORT, CT		
DRAWING: 1 OF 1	REVISION:	DATE:
DRAWN BY: LSR		
SCALE: 1/4"= 1'-0		
DATE: 8-28-20		
DRAWING FILE:		

A-1

8·28·20